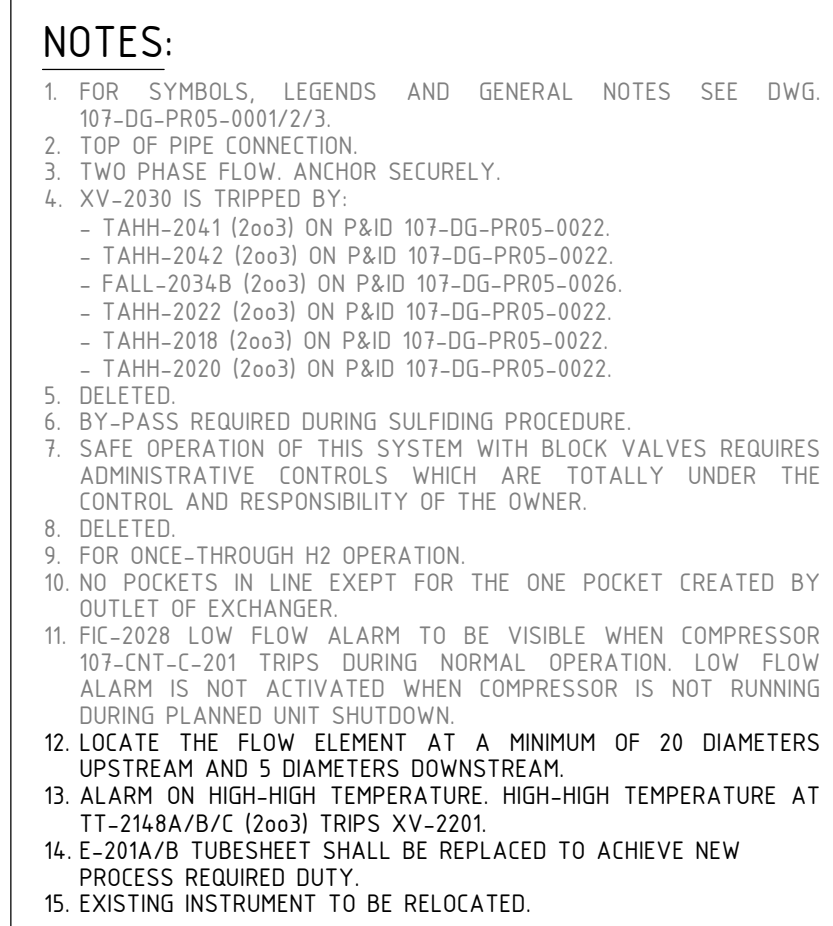


[illegible]

 Refinería de Cartagena S.A.S.	
--	---

VICEPRESIDENCIA DE DESARROLLO, PROYECTOS Y PERFORACIÓN
INGENIERIA BASICA PROYECTO MEJORAS EN UNIDAD DE DESTILACIÓN REACTIVA U-107
PARA ESTABILIDAD Y CUMPLIMIENTO DE 10 PPM AZUFRE

FCC NAPHTHA HYDROTREATER PIPING AND INSTRUMENTATION
DIAGRAM COHDS/H2S STRIPPER COHDS FEED/OVERHEAD EXCHANGERS

PROYECTO No./PROJECT No: 360314	CÓDIGO EC: 107-DG-PR05-0021	REV: D4
	CÓDIGO ECP: GRC-107-PRO-PID-000008	

	ONDT 2014	AS BUILT	DPS		KS	KS			
	SLAGC 2012	ISSUED FOR CONSTRUCTION	LN		HA	KS			
	STALIG 2011	ISSUED FOR CONSTRUCTION	LN		HA	KW			
	330C 2010	ISSUED FOR CONSTRUCTION	JL		HA	KW			
	58MA 2010	ISSUED FOR PHA	LN		HA	KW			
REV	ISSUE DATE	DESCRIPTION	DWN	CHKD	LEAD DES	ORIG ENG	SUPP ENR	PROJ	CLIENT







THIS DOCUMENT IS THE PROPERTY OF CHICAGO BRIDGE & IRON COMPANY ("CB&I"). IT MAY CONTAIN INFORMATION DESCRIBING TECHNOLOGY OWNED BY CB&I AND DEEMED TO BE COMMERCIALY SENSITIVE. IT IS TO BE USED ONLY IN CONNECTION WITH WORK BEING PERFORMED BY CB&I. REPRODUCTION IN WHOLE OR IN PART FOR ANY PURPOSE OTHER THAN WORK PERFORMED BY CB&I IS FORBIDDEN EXCEPT BY EXPRESS WRITTEN PERMISSION OF CB&I. IT IS TO BE SAFEGUARDED AGAINST BOTH DELIBERATE AND INADVERTENT DISCLOSURE TO ANY THIRD PARTY.

FCC NAPHTHA HYDROTREATER
PIPING AND INSTRUMENTATION DIAGRAM
CDHDS/H₂S STRIPPER
CDHDS FEED/OVERHEAD EXCHANGERS

CARTAGENA REFINERY		CARTAGENA, COLOMBIA.	
SCALE:	DWG. No:	REV:	
NONE	107-DG-PR05-0021	9	